




North West Elevation

PLEASE NOTE: Check all dimensions on site.

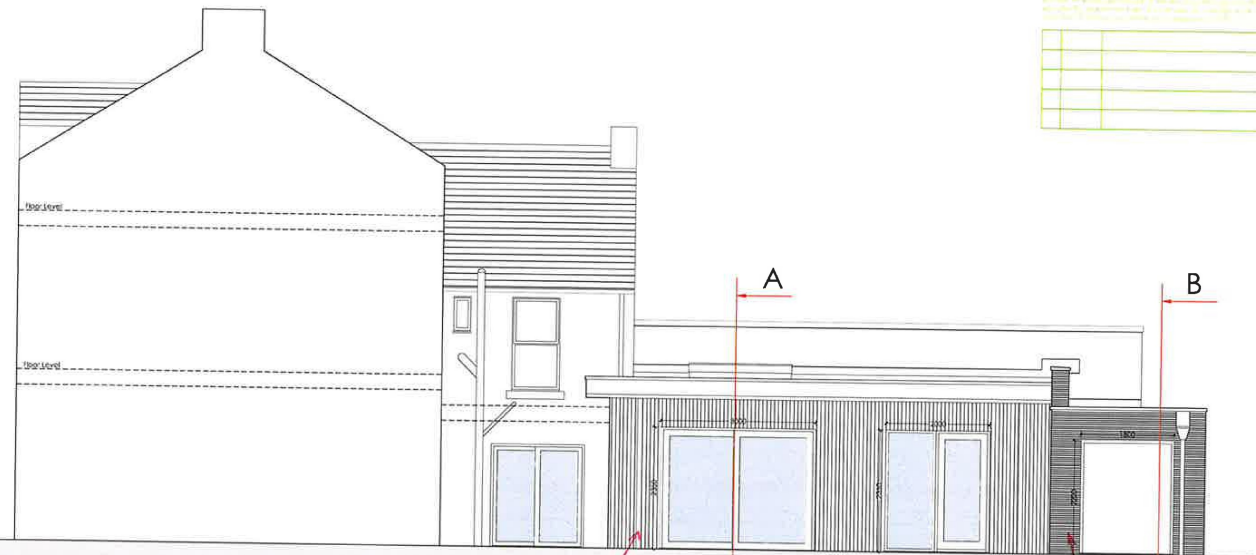


South West Elevation


'IROTIMBE'
CHARCOAL CLADDING
FIXED VERTICALLY.

K-REND WHITE
RENDER TO GARAGE/
STORE

PLEASE NOTE: Measured survey was carried out by client. Floor level and ground level relationships to be checked on site with levels adjusted accordingly and all agreed with client and LABC on site. A threshold drainage channel will be required where the internal floor level is the same as the external levels.

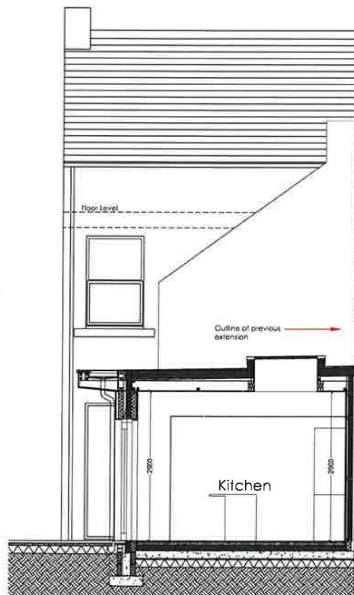

South East Elevation
Section AA

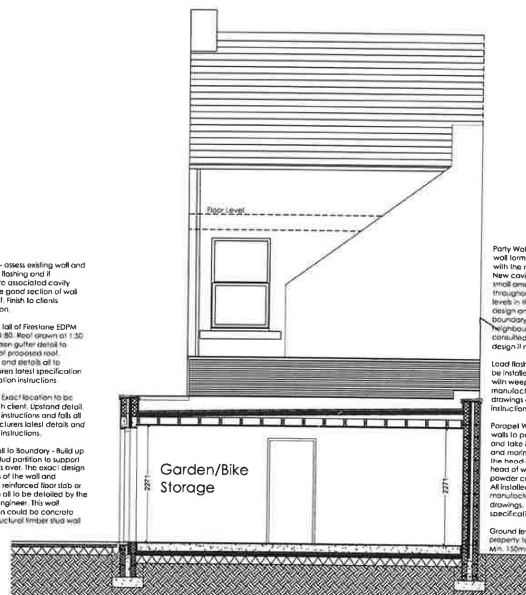

South East Elevation
Section BB

ALL DRAWINGS SUBJECT TO BUILDING REGULATIONS APPROVAL
TO BE READ IN CONJUNCTION WITH STRUCTURAL ENGINEER'S
DRAWINGS AND DETAILED CALCULATIONS.



Proposed 3D Model Images

RED LINED DRAWING
RYAN CHRISTIE 30/5/2022

Proposed Elevations and
Section A-A and B-B

Alterations and Extensions to
Longlands, Whinney Hill
Cleator Moor
for Mr and Mrs Christie

DRAWING NO. 19/39.06
SCALE: 1:100 @ A1
DRAWN BY: PK
DRAWING NO. MAY 2020

WK
DESIGN
ARCHITECTS

43 The Mount | Papeete | Cook Islands | Contact: 011 612 012
Email: wkdesign@wkdesign.co.uk | www.wkdesign.co.uk
Twitter: @wkdesign | Facebook: wkdesign | LinkedIn: wkdesign